



Draft Schematic CONNECTION DIAGRAM for Chris McKinnon's High Frequency ARC STARTER

*Drawn by Chris M 8-5-2006. I edited the bottom circuit based on Chris' photo of what he built.
Revised 8- 6-2006 NOTHING YOU SEE HERE HAS BEEN TESTED BY JON PARDUE.
I AM WORKING WITH THIS IN MY LAB AND WILL POST RESULTS ASAP.*

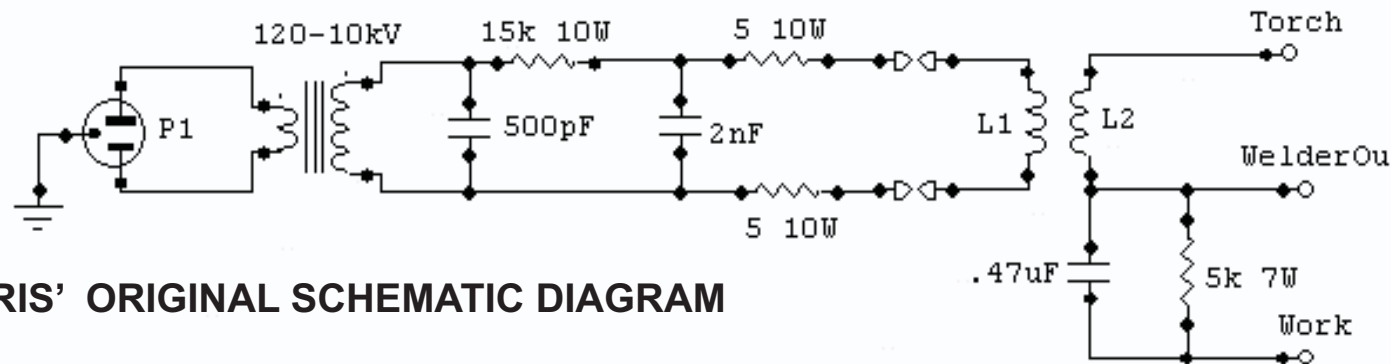

CHRIS' ORIGINAL SCHEMATIC DIAGRAM

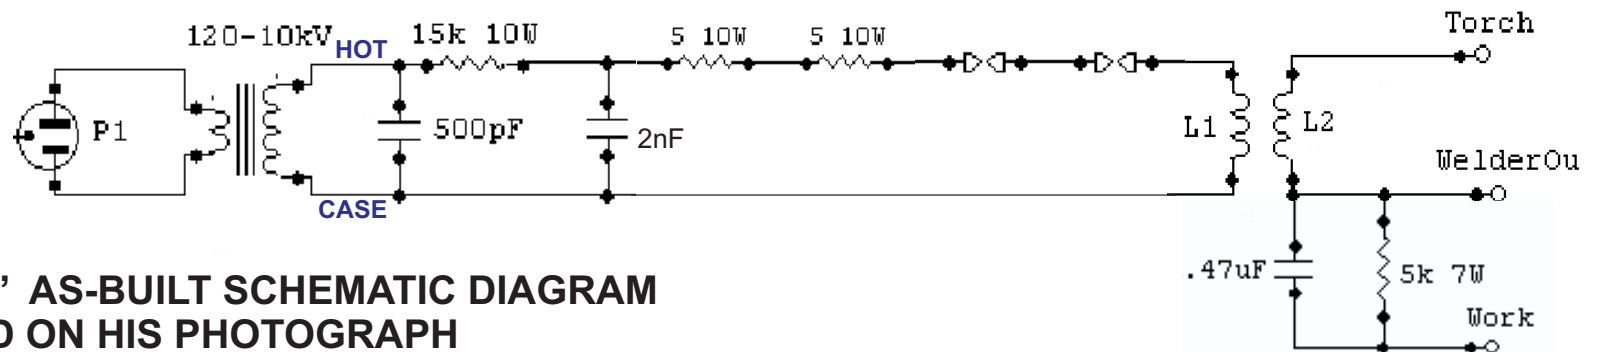

**CHRIS' AS-BUILT SCHEMATIC DIAGRAM
BASED ON HIS PHOTOGRAPH**

Chris' circuit drawn by Jon Pardue 8-5-2006